
## City of St. Charles Kane and DuPage Counties

## ACCEPTANCE RESOLUTION

Subdivision Name: 7 S 2 <sup>nd</sup> Ave
Whereas Frontier Development, the Developer of
7 S 2 <sup>nd</sup> Ave (Idle Hour Theater) , constructed public sanitary sewer and watermain and appurtenances in
easements as described in the attached exhibits in the aforesaid Subdivision; and
Whereas, the Developer has constructed public sanitary sewer and watermain and
appurtenances in accord with the plans and specifications, heretofore approved by the City of St. Charles;
and
Whereas, the constructed public sanitary sewer and watermain and appurtenances have
been inspected by the Engineer for the sub divider and by a representative for the City of St. Charles and
are found to be satisfactory;
Now, Therefore, Be It Resolved by the City Council of St. Charles, that said Council
hereby approves and accepts the constructed public sanitary sewer and watermain and appurtenances. It
being understood that this acceptance and/or approval in no way relieves the Developer of his Surety of
any obligation for maintenance for a period of one (1) year as provided for in said Contract.
Passed by the City Council of the City of St. Charles, thisday of, 2024,
and APPROVED by the Mayor of said City of St. Charles, this day of, 2024.
MAYOR
ATTEST:
CITY CLERK

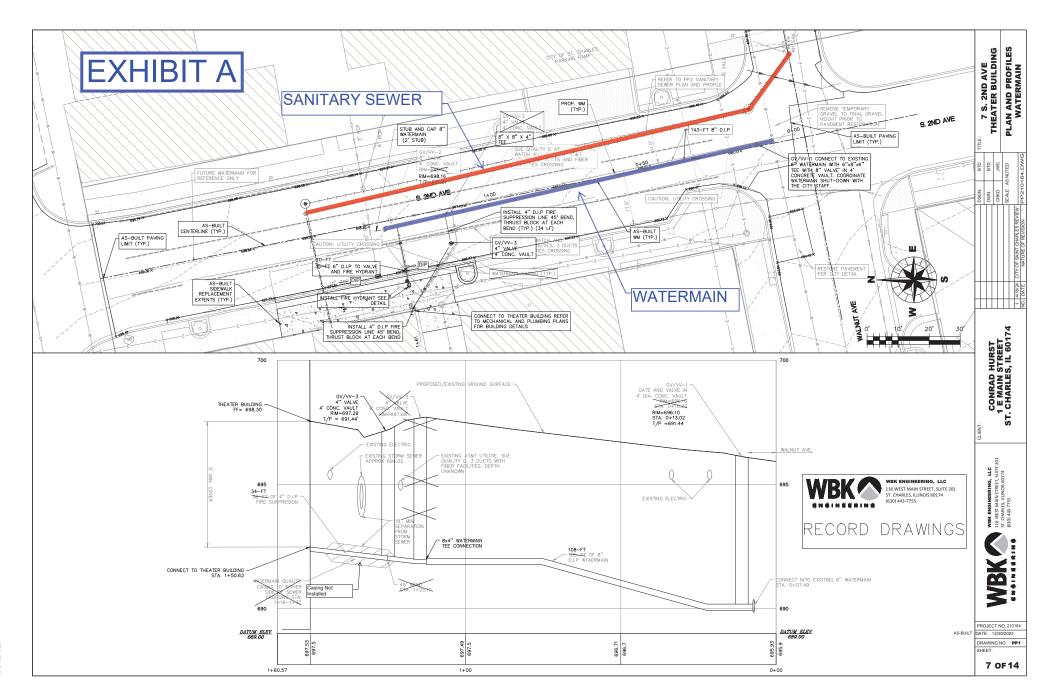

MOLATION - MINISTER COLL